



Appendix A.1: Faith Valley As-Built Drawings 2024 Adaptive Management

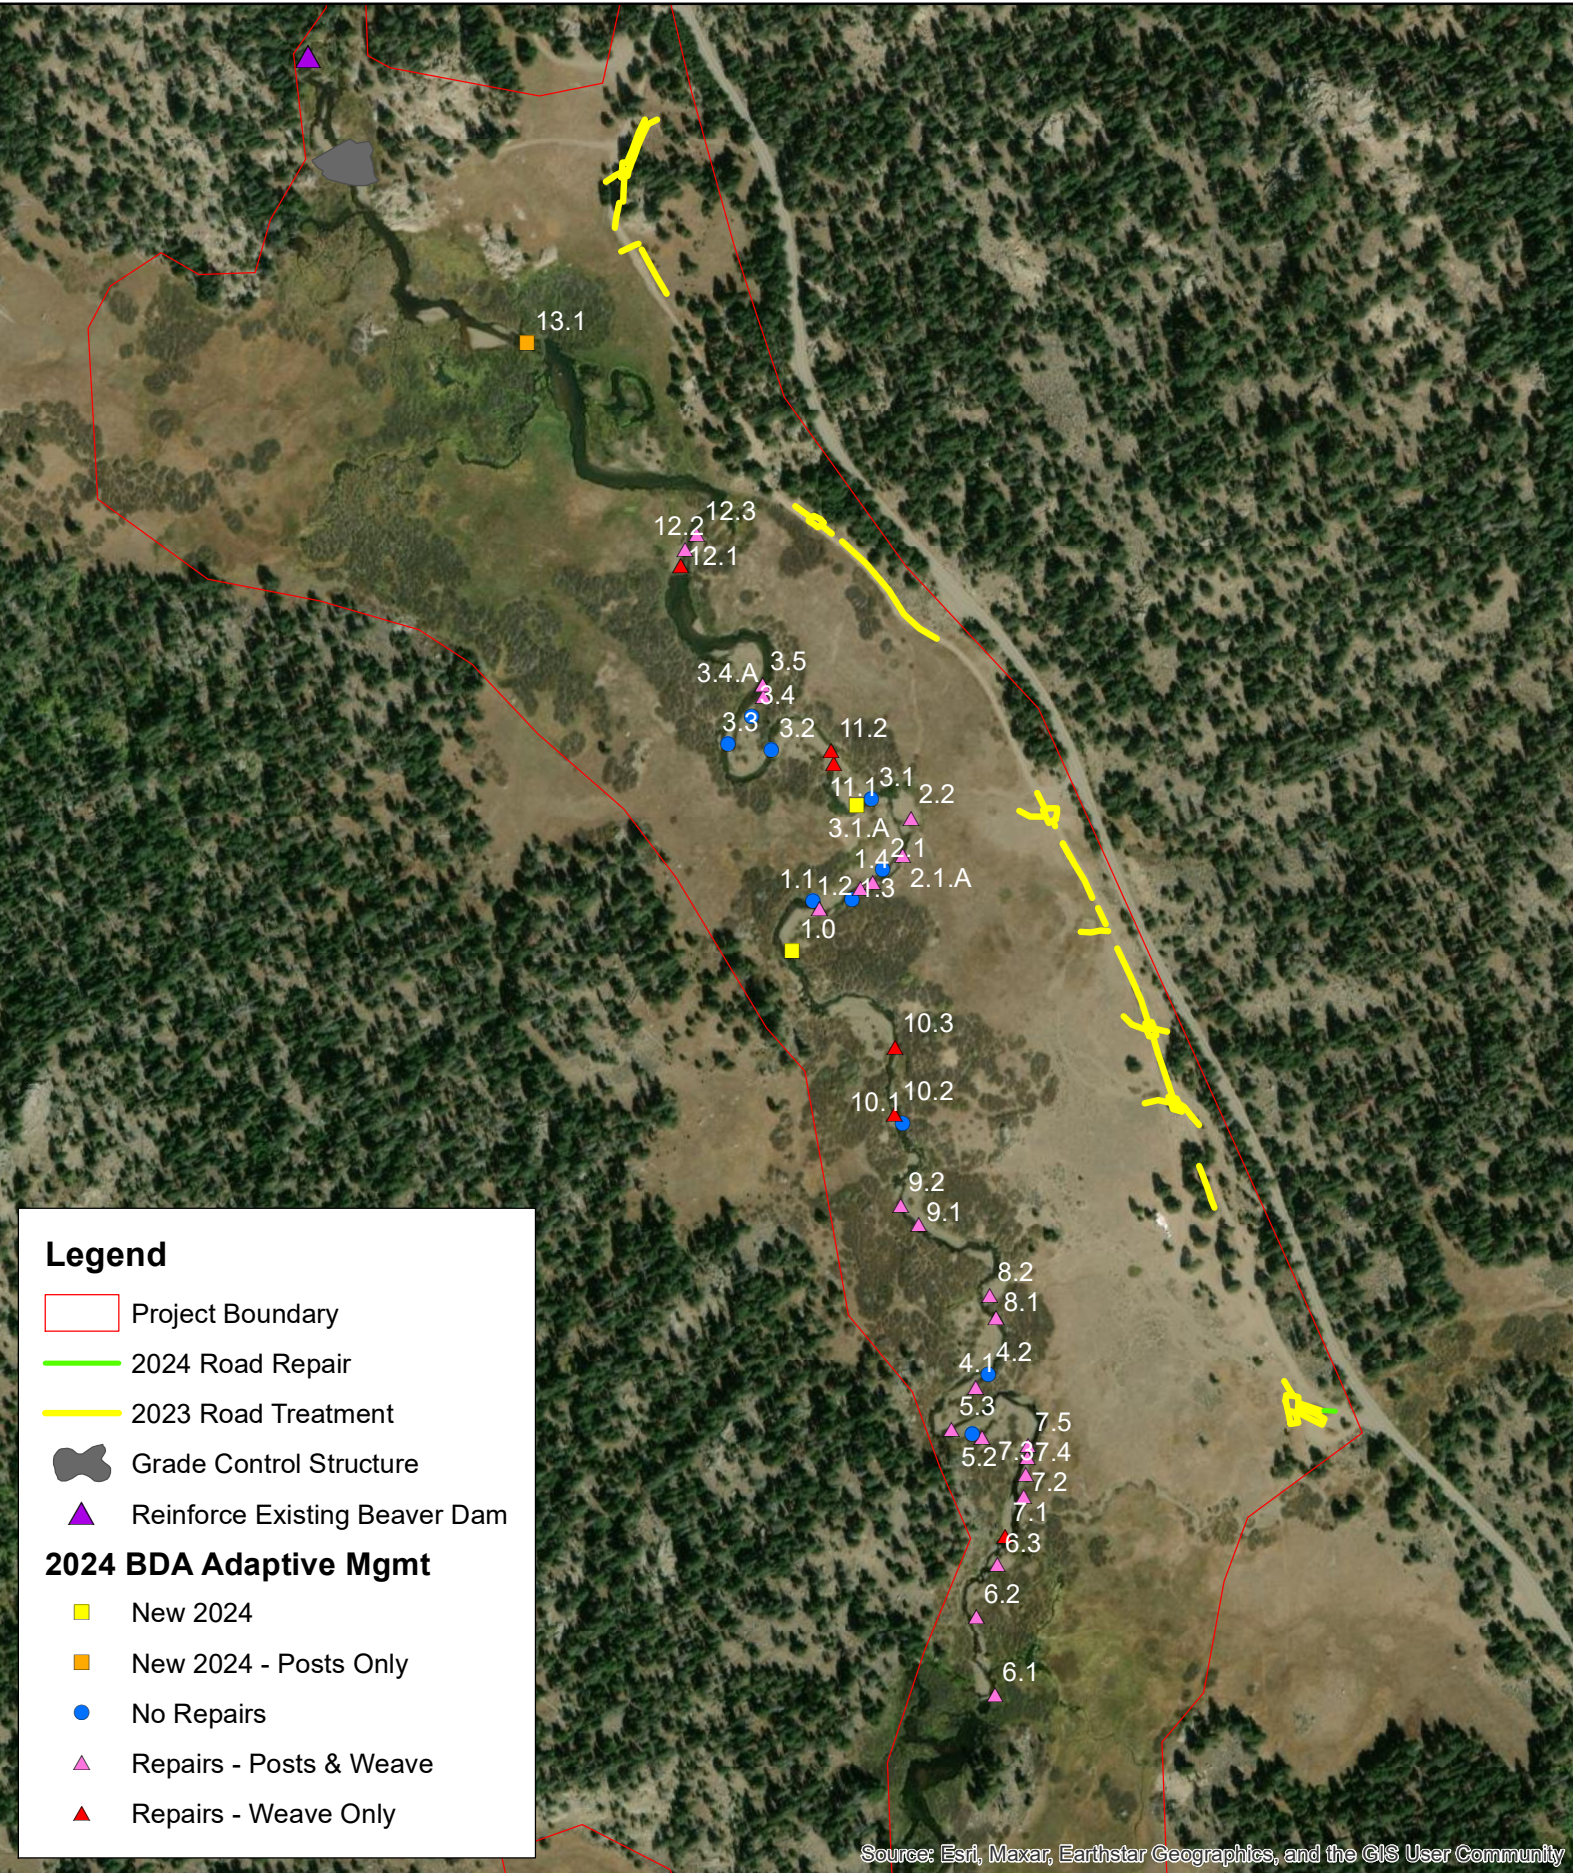

Source: Esri, Maxar, Earthstar Geographics, and the GIS User Community

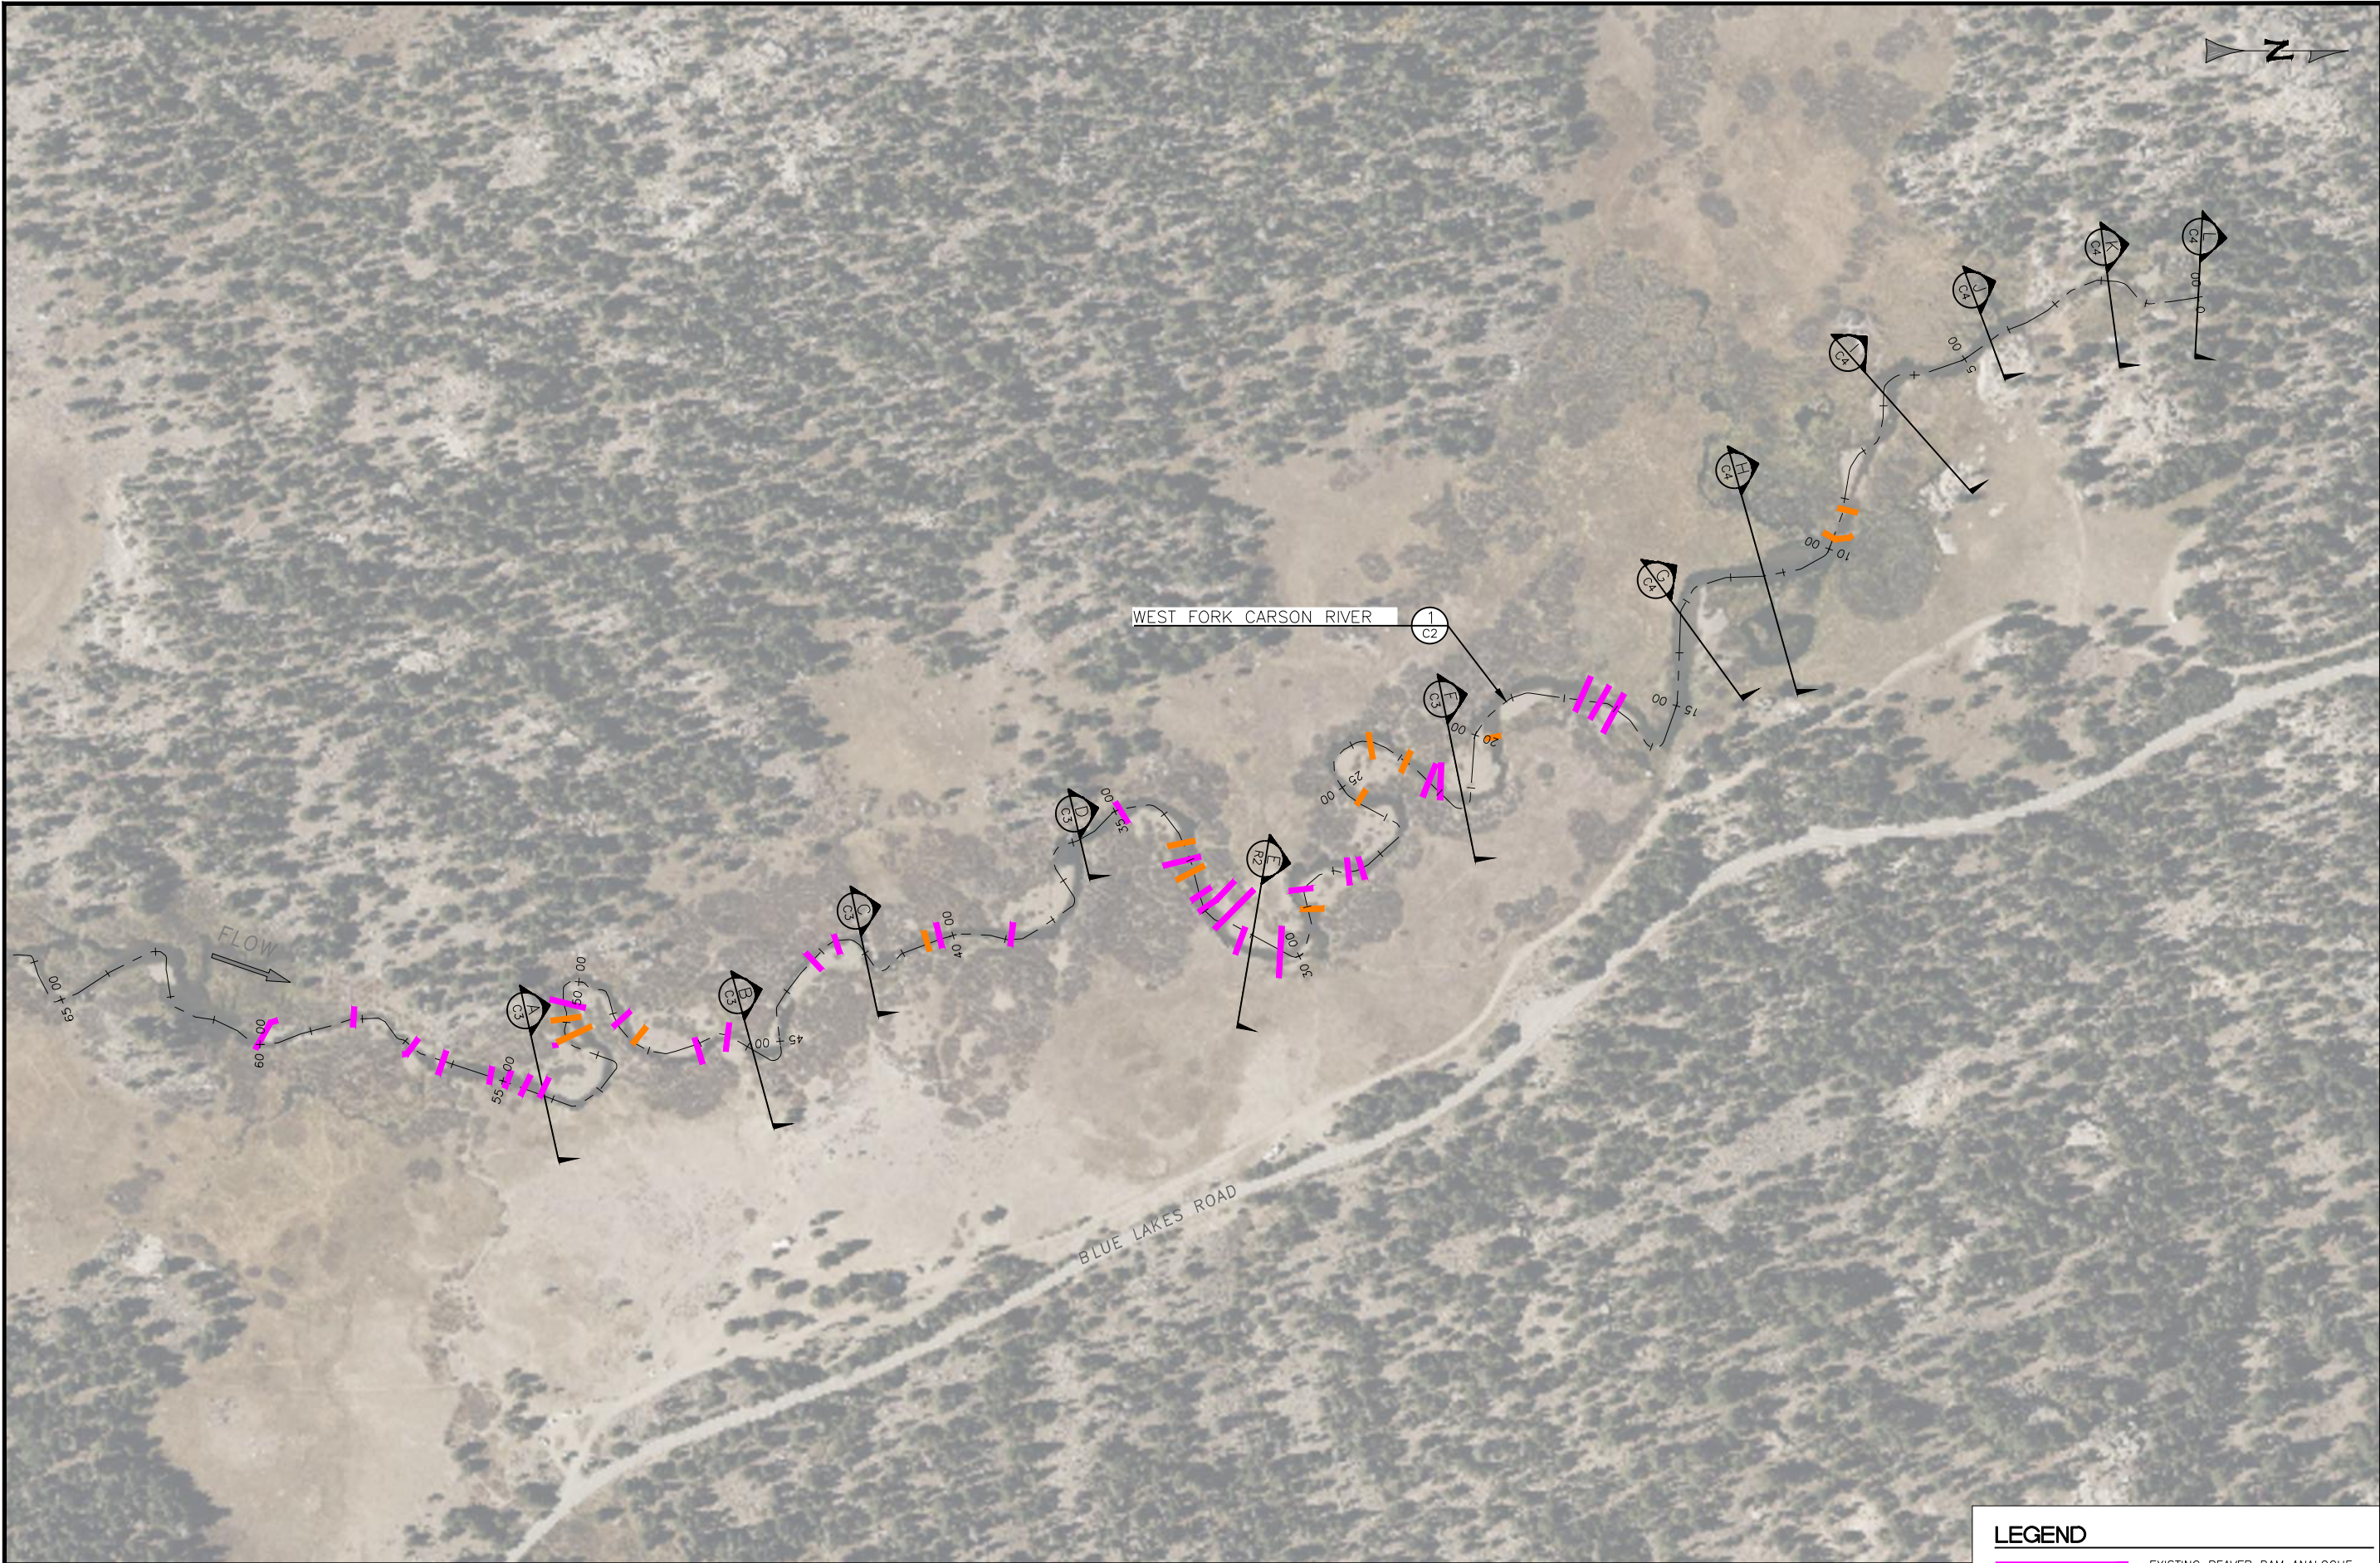


SITE PLAN
SCALE: 1" = 150'

LEGEND

- EXISTING BEAVER DAM ANALOGUE
- EXISTING POST LINE

DESIGNED BY: M.W.
DRAWN BY: P.L.
CHECKED BY: M.W.
DATE: 3/21/25
JOB NO.: 17-072

BAR IS ONE INCH ON
ORIGINAL DRAWING,
ADJUST SCALES FOR
REDUCED PLOTS
0 1"

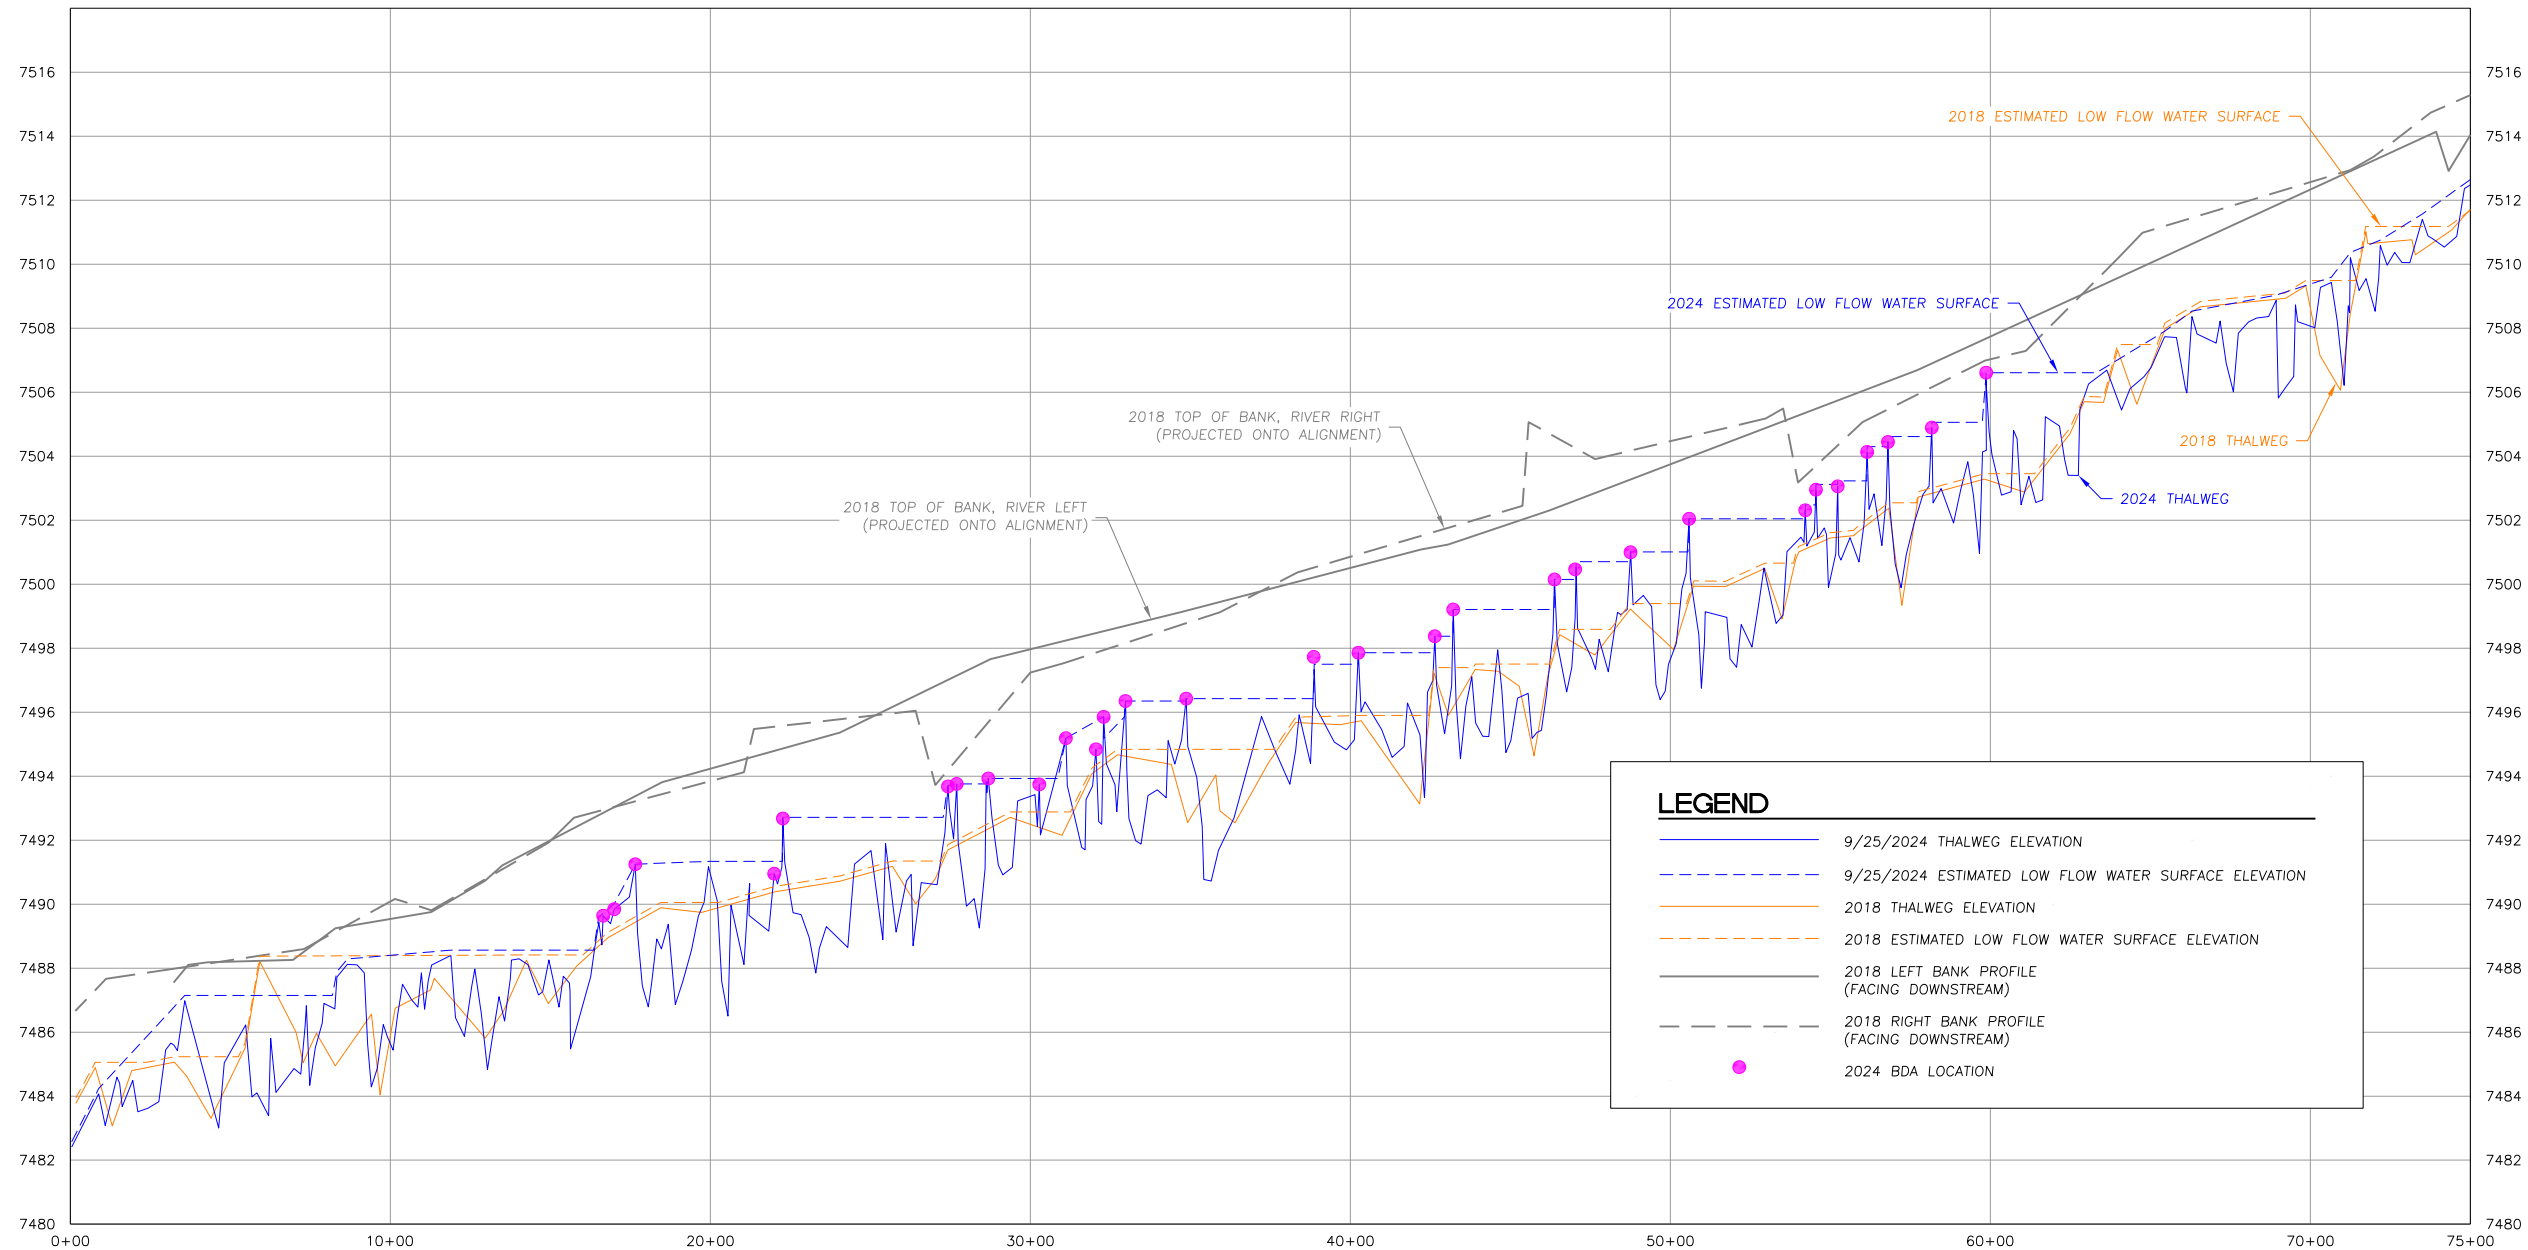


LONG PROFILE
SCALE: HORIZONTAL: 1" = 300' VERTICAL: 1" = 4' 

LEGEND

- 9/25/2024 THALWEG ELEVATION
- 9/25/2024 ESTIMATED LOW FLOW WATER SURFACE ELEVATION
- 2018 THALWEG ELEVATION
- 2018 ESTIMATED LOW FLOW WATER SURFACE ELEVATION
- 2018 LEFT BANK PROFILE (FACING DOWNSTREAM)
- 2018 RIGHT BANK PROFILE (FACING DOWNSTREAM)
- 2024 BDA LOCATION

- NOTES:
- 2018 THALWEG ELEVATION INCLUDES DATA FROM THREE SURVEYS BETWEEN 6/26/18 AND 10/9/18.
 - LOW FLOW WATER SURFACE ELEVATIONS ARE ASSUMED BASED ON THALWEG ELEVATION. ASSUMING 2 INCHES OF DEPTH ON RIFFLES AND A FLAT WATER SURFACE AT POOLS.

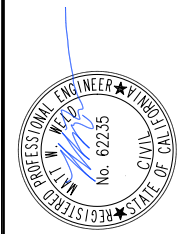








PREPARED AT THE REQUEST OF:
AMERICAN RIVERS

LONG PROFILE

FAITH MEADOW
RESTORATION
RECORD DRAWING

 DESIGNED BY: M.W.
DRAWN BY: P.L.
CHECKED BY: M.W.
DATE: 3/21/25
JOB NO.: 17-072

BAR IS ONE INCH ON
ORIGINAL DRAWING,
ADJUST SCALES FOR
REDUCED PLOTS

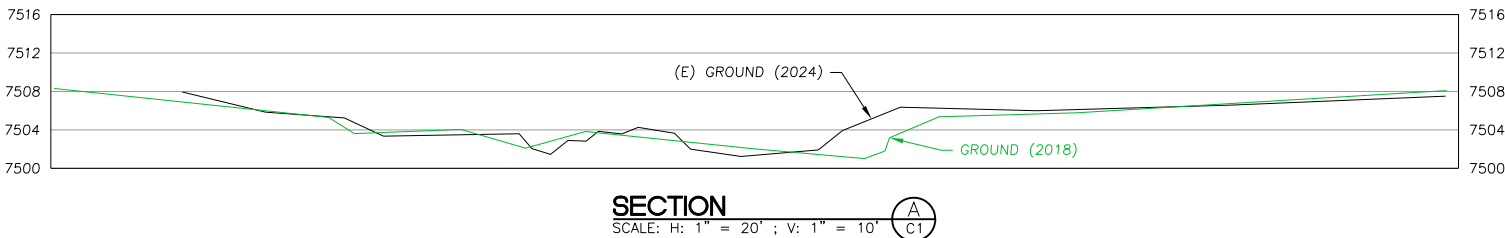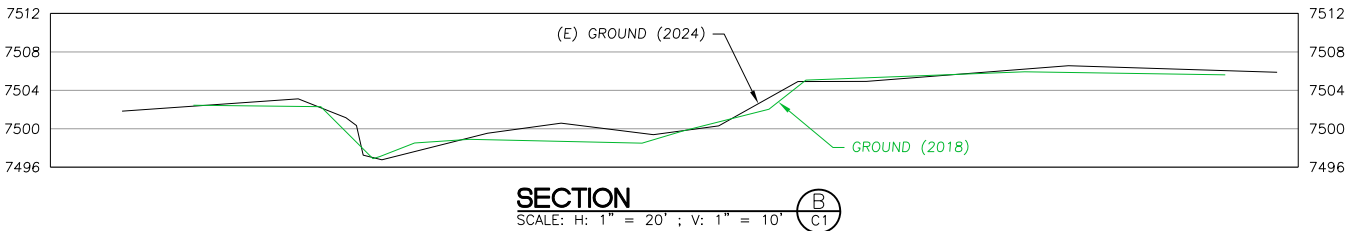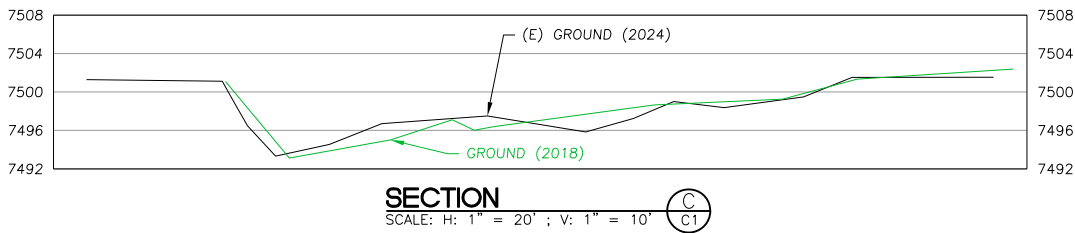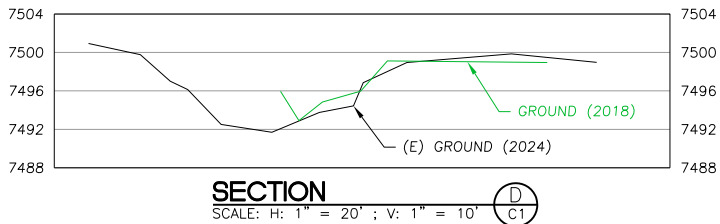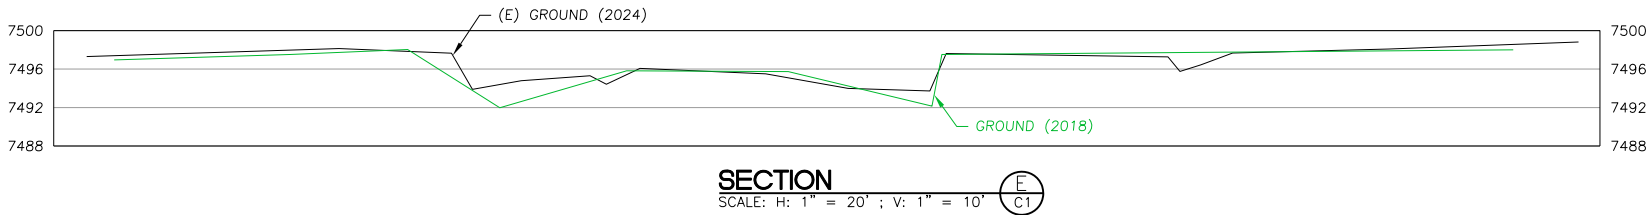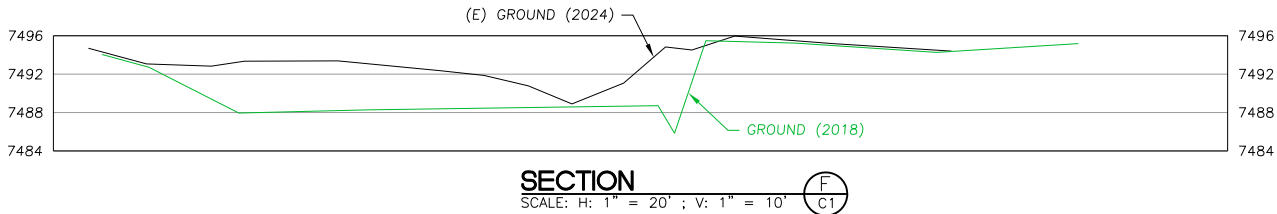


PREPARED AT THE REQUEST OF:
AMERICAN RIVERS

SECTIONS
(1 OF 2)







FAITH MEADOW
RESTORATION
RECORD DRAWING

DESIGNED BY:	M.W.
DRAWN BY:	P.L.
CHECKED BY:	M.W.
DATE:	3/21/25
JOB NO.:	17-072

BAR IS ONE INCH ON
ORIGINAL DRAWING,
ADJUST SCALES FOR
REDUCED PLOTS

0

1"

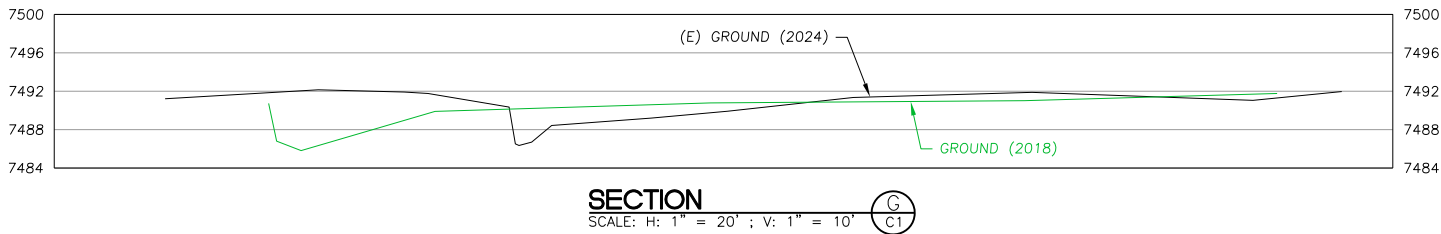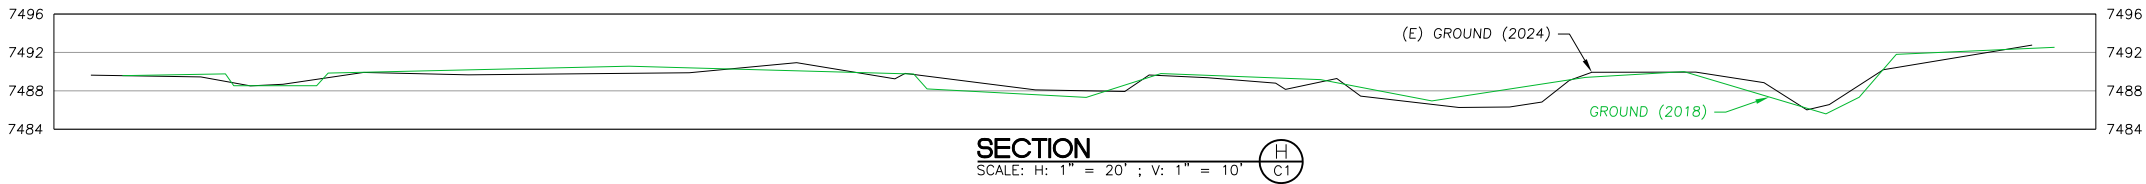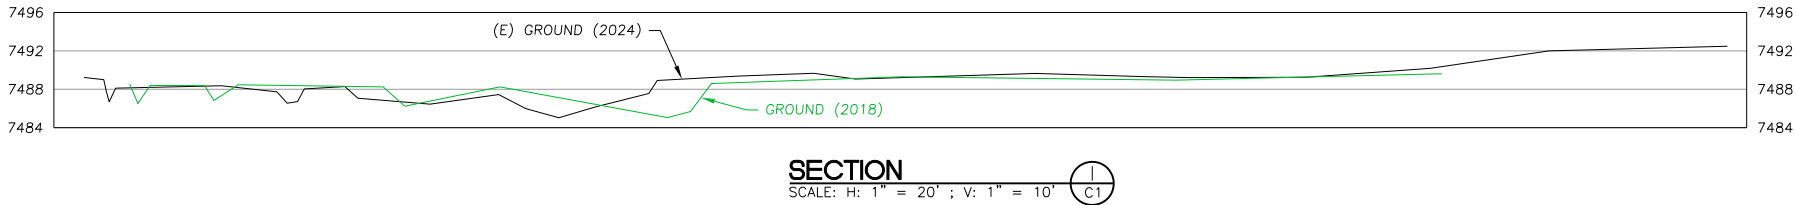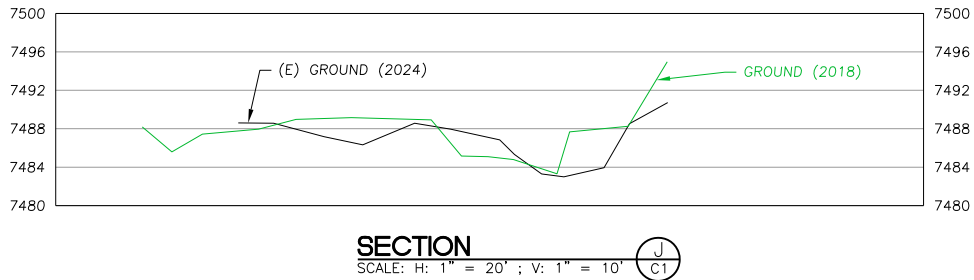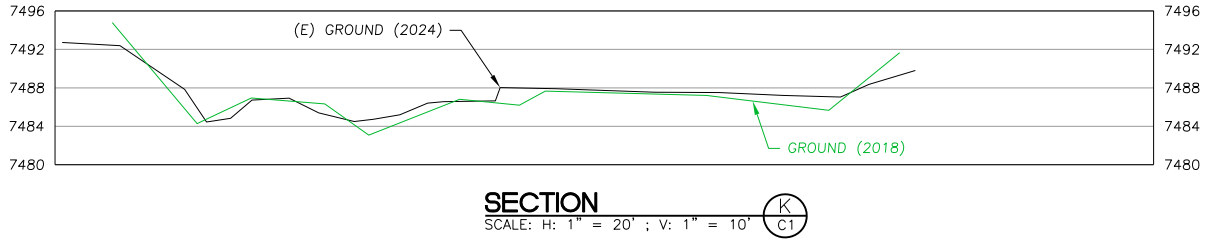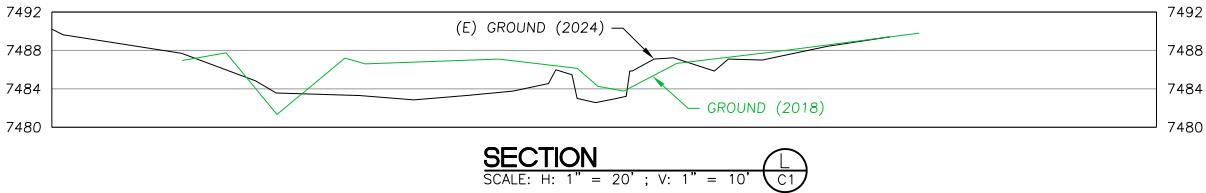

PREPARED AT THE REQUEST OF:
AMERICAN RIVERS

SECTIONS
(2 OF 2)

FAITH MEADOW
RESTORATION
RECORD DRAWING

DESIGNED BY:	M.W.
DRAWN BY:	P.L.
CHECKED BY:	M.W.
DATE:	3/21/25
JOB NO.:	17-072

BAR IS ONE INCH ON
ORIGINAL DRAWING,
ADJUST SCALES FOR
REDUCED PLOTS

1"